

Date: Wednesday, 2/15/2006 3:46:47 PM
 Ser: Kim Johnston

Process Sheet

Customer : CU-DAR001 Dart Helicopters Services	Drawing Name : BASKET RIB
Job Number : 25844	
Estimate Number : 10402	
P.O. Number : N/A	Part Number : D31661
This Issue : 2/15/2006 S.O. No. : N/A	Drawing Number : D3166 REV A1
Prsht Rev. : NC	Project Number : N/A
First Issue : N/A Type : LANDING GEAR	Drawing Revision : A1
Previous Run : 25478	Material : N/A
Written By : SEE COMMENT BELOW.	Due Date : 2/28/2006 Qty: 40 Um: Each
Checked & Approved By : PD 06.02.16	
Comment : Est. A 02.08.23 New issue KJ	

Additional Product

Job Number:



Seq. #:

Machine Or Operation:

Description :

1.0

M304TS0750W065

304 SQ Tube.75x.75x.065W



Comment: Qty.: 5.000 f(s)/Unit Total : 200.0000 f(s)

304 SQ Tube.75x.75x.065W

(M304TS0750W065)

Material: 304/316 SS tube 0.065" wall

Batch M100138 (20')

M100023 (20')

PD 06-02-23

2.0

LANDING GEAR 1

LANDING GEAR RESOURCE 1



Comment: LANDING GEAR RESOURCE 1

Cut 3/4" x 3/4" square tubing 60.00" long.

PD 06-02-23 (40)

3.0

BENDING

BENDING MACHINE



Comment: BENDING MACHINE

Form D3166-1 Basket Hoop as per Dwg D3166 using Bending program 350 BASB, and folio FT004.

PD 06-02-25 (40)

4.0

QC6

DIMENSIONAL CHECK



Comment: DIMENSIONAL CHECK

Inspect Basket Hoop dimensions with template D3166-1-T1 (DT8302)

PD 06/02/27 (40)

5.0

PACKAGING 1

PACKAGING RESOURCE #1



Comment: PACKAGING RESOURCE #1

Identify and Stock

Location: LG

PD 06-02-25 (40)

Dart Aerospace Ltd

W/O:		WORK ORDER CHANGES					
DATE	STEP	PROCEDURE CHANGE	By	Date	Qty	Approval Chief Eng / Prod Mgr	Approval QC Inspector

Part No: _____ PAR #: _____ Fault Category: _____ NCR: Yes ☒ No ☐ DQA: DD Date: 06/03/27
 QA: N/C Closed: _____ Date: _____

NCR:		WORK ORDER NON-CONFORMANCE (NCR)						
DATE	STEP	Description of NC Section A	Corrective Action Section B			Verification Section C	Approval Chief Eng	Approval QC Inspector
			Initial Chief Eng	Action Description Chief Eng	Sign & Date			

NOTE: Date & initial all entries

Date: Wednesday, 2/15/2006 3:46:47 PM
User: Kim Johnston

Process Sheet

Customer: CU-DAR001 Dart Helicopters Services

Drawing Name: BASKET RIB

Job Number: 25844

Part Number: D31661

Job Number:



Seq. #:

Machine Or Operation:

Description :

6.0

DC

DOCUMENT CONTROL



Comment: DOCUMENT CONTROL
Inspection Level 21

06/22/27

Job Completion



060227

Dart Aerospace Ltd

W/O:		WORK ORDER CHANGES					
DATE	STEP	PROCEDURE CHANGE	By	Date	Qty	Approval Chief Eng / Prod Mgr	Approval QC Inspector

Part No: _____ PAR #: _____ Fault Category: _____ NCR: Yes No DQA: _____ Date: _____

QA: N/C Closed: _____ Date: _____


NCR:		WORK ORDER NON-CONFORMANCE (NCR)						
DATE	STEP	Description of NC Section A	Corrective Action Section B			Verification Section C	Approval Chief Eng	Approval QC Inspector
			Initial Chief Eng	Action Description Chief Eng	Sign & Date			

NOTE: Date & initial all entries



DESIGN #	DRAWN BY CP	DART AEROSPACE LTD HAWKESBURY, ONTARIO, CANADA	
CHECKED #	APPROVED #	DRAWING NO. D3166	REV. A SHEET 1 OF 1
DATE 02.07.10		TITLE BASKET HOOP	SCALE NTS
A	02.07.10	NEW ISSUE	
A1	04.04.08	38+/-1 WAS 36.0	


RELEASED
02.08.06

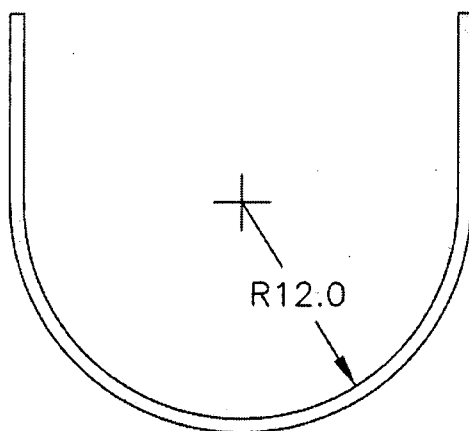

10.6 (REF, NEED 8.0 MIN)

D3166-1 BASKET HOOP

- 1) MATERIAL: AISI 304/316 SS SQUARE TUBING,
0.75" x 0.75" x 0.063 WALL, 60.00" LONG
(REF DART SPEC. M304TS0.750W.063)
- 2) FINISH: NONE
- 3) TOLERANCES ARE PER DART QSI 018 UNLESS
OTHERWISE NOTED

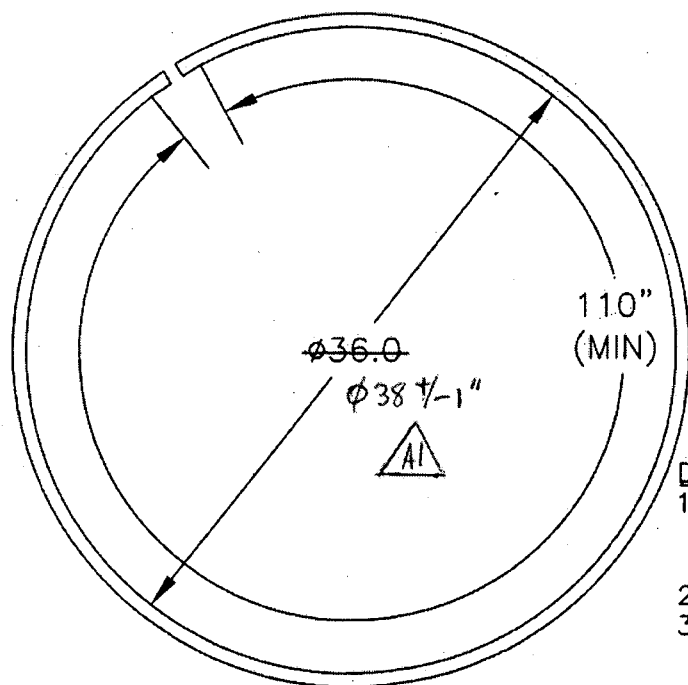

SHOP COPY
RETURN TO
ENGINEERING
UNCONTROLLED COPY
SUBJECT TO AMENDMENT
WITHOUT NOTICE
WORK ORDER
NO. 25844

D3166-3 BASKET HOOP

- 1) MATERIAL: AISI 304/316 SS SQUARE TUBING,
0.75" x 0.75" x 0.063 WALL, 120.00" LONG
(REF DART SPEC. M304TS0.750W.063)
- 2) FINISH: NONE
- 3) TOLERANCES ARE PER DART QSI 018 UNLESS
OTHERWISE NOTED

Copyright © 2002 by DART AEROSPACE LTD

THIS DOCUMENT IS PRIVATE AND CONFIDENTIAL AND IS SUPPLIED ON THE EXPRESS CONDITION THAT IT IS NOT TO BE USED FOR ANY PURPOSE OR COPIED OR COMMUNICATED TO ANY OTHER PERSON WITHOUT WRITTEN PERMISSION FROM DART AEROSPACE LTD.